

# **DART SERVICE INSTRUCTION**

TO AMEND INSTALLATION INSTRUCTIONS D206-642 REV. L AND  
INSTRUCTIONS FOR CONTINUED AIRWORTHINESS ICA-D206-642 REV. 1




REF. CANADIAN STC: SH98-4

REF. FAA STC: SA00475SE

REF. EASA STC: EASA.IM.R.S.01320

## **INSTRUCTIONS:**

- 1) FOR D206-642-111/-112/-211/-212/-213/-214 SKIDTUBES @ CHANGE 005 AND SUBSEQUENT, MODIFY THE FOLLOWING:
- a) REPLACE THE CARBON STEEL WEAR PADS AND WEARSHOES WITH STAINLESS STEEL WEARPADS AND WEARSHOES PER THE UPDATED PARTS LIST ON SHEET 2.
  - b) ADD NEOPRENE GASKETS BETWEEN THE SKIDTUBE AND WEARSHOES PER THE UPDATED PARTS LIST ON SHEET 2 AND PER FIGURE 1 ON SHEET 4.
  - c) REPLACE THE CARBON STEEL FASTENERS FOR THE WEARPADS AND WEARSHOES WITH STAINLESS STEEL FASTENERS PER THE UPDATED PARTS LIST ON SHEET 2.
  - b) AMEND THE PARTS LIST IN SECTIONS 4.1 AND 4.2 OF INSTALLATION INSTRUCTIONS D206-642 REV. L OR EARLIER AND SECTIONS 32.10 AND 32.11 OF THE INSTRUCTIONS FOR CONTINUED AIRWORTHINESS ICA-D206-642 REV. 1 OR EARLIER AS SHOWN ON SHEET 2.
- 2) FOR D206-642-311/-312/-411/-412 SKIDTUBES @ CHANGE 006 AND SUBSEQUENT, MODIFY THE FOLLOWING:
- a) REPLACE THE CARBON STEEL WEAR PADS AND WEARSHOES WITH STAINLESS STEEL WEARPADS AND WEARSHOES PER THE UPDATED PARTS LIST ON SHEET 3.
  - b) ADD NEOPRENE GASKETS BETWEEN THE SKIDTUBE AND WEARSHOES PER THE UPDATED PARTS LIST ON SHEET 3 AND PER FIGURE 2 ON SHEET 4.
  - c) REPLACE THE CARBON STEEL FASTENERS FOR THE WEARPADS AND WEARSHOES WITH STAINLESS STEEL FASTENERS PER THE UPDATED PARTS LIST ON SHEET 3.
  - d) AMEND THE PARTS LIST IN SECTIONS 4.3 AND 4.4 OF INSTALLATION INSTRUCTIONS D206-642 REV. L OR EARLIER AND SECTIONS 32.12 AND 32.13 OF THE INSTRUCTIONS FOR CONTINUED AIRWORTHINESS ICA-D206-642 REV. 1 OR EARLIER AS SHOWN ON SHEET 3.

B	P/N CORRECTION	AJS	09.03.25
A	NEW ISSUE	AJS	08.12.19
REV.	DESCRIPTION	BY	DATE
DESIGN	AJS	<b>DART AEROSPACE LTD</b> HAWKESBURY, ONTARIO, CANADA	
DRAWN	AJS		
CHECKED		DRAWING NO.	REV. B
MFG. APPR.	N/A	DSI 9440	SHEET 1 OF 4
APPROVED		TITLE	SCALE
DE APPR.		WEARSHOE CHANGE	NTS
DATE	09.03.25	COPYRIGHT © 2008 BY DART AEROSPACE LTD <small>THIS DOCUMENT IS PRIVATE AND CONFIDENTIAL AND IS SUPPLIED ON THE EXPRESS CONDITION THAT IT IS NOT TO BE USED FOR ANY PURPOSE OR COPIED OR COMMUNICATED TO ANY OTHER PERSON WITHOUT WRITTEN PERMISSION FROM DART AEROSPACE LTD.</small>	

4.1 206 A/B Low Gear Skidtubes (D206-642)  
32.10 206 A/B Low Gear Skidtubes (ICA-D206-642)

ITEM	Qty -111	Qty -112	Qty -141	Qty -147	PART NUMBER	DESCRIPTION
	X				D206-642-111	SKIDTUBE INSTALLATION, LH
		X			D206-642-112	SKIDTUBE INSTALLATION, RH
	1	1	X		D206-642-141	SKIDTUBE
				X	D206-642-147	WEARSHOE KIT (REPLACES -143)
	1	1			D206-651-041	* 206 GHW ADAPTER <sup>(1)</sup>

IS:

20A			4		D3537-1	WEARPAD (REPLACES D2648-3)	(MODIFY)
21A			1		D3537-3	WEARPAD (REPLACES D3429-1)	(MODIFY)
22A			1	1	D3535-11	WEARSHOE (REPLACES D2656-11)	(MODIFY)
22B			1	1	D3536-11	GASKET	(ADD)
23A			1	1	D3535-21	WEARSHOE (REPLACES D2656-21)	(MODIFY)
23B			1	1	D3536-21	GASKET	(ADD)
24A			1	1	D3535-31	WEARSHOE (REPLACES D2656-31)	(MODIFY)
24B			1	1	D3536-31	GASKET	(ADD)
26A			42		MS27039-1C08	SCREW	(MODIFY)
26B			42		AN960C10L	WASHER	(MODIFY)

WAS:

20A			4		D2648-3	WEARPAD
21A			1		D3429-1	WEARPAD
22A			1	1	D2656-11	WEARSHOE
23A			1	1	D2656-21	WEARSHOE
24A			1	1	D2656-31	WEARSHOE
26A			42		MS27039-1-08	SCREW
26B			42		AN960JD10L	WASHER

4.2 206 A/B High Gear Skidtubes (D206-642)  
32.11 206 A/B High Gear Skidtubes (ICA-D206-642)

ITEM	Qty -211	Qty -212	Qty -213	Qty -214	Qty -241	Qty -247	PART NUMBER	DESCRIPTION
	X						D206-642-211	SKIDTUBE INSTALLATION, LH
		X					D206-642-212	SKIDTUBE INSTALLATION, RH
			X				D206-642-213	SKIDTUBE INSTALLATION, LH, THRU BOLT
				X			D206-642-214	SKIDTUBE INSTALLATION, RH, THRU BOLT
	1	1	1	1	X		D206-642-241	SKIDTUBE
						X	D206-642-247	WEARSHOE KIT (REPLACES -243)
	1	1	1	1			D206-651-041	* 206 GHW ADAPTER <sup>(1)</sup>

IS:

20A					4		D3537-1	WEARPAD (REPLACES D2648-3)	(MODIFY)
21A					1		D3537-3	WEARPAD (REPLACES D3429-1)	(MODIFY)
22A					1	1	D3535-13	WEARSHOE (REPLACES D2656-13)	(MODIFY)
22B					1	1	D3536-13	GASKET	(ADD)
23A					1	1	D3535-21	WEARSHOE (REPLACES D2656-21)	(MODIFY)
23B					1	1	D3536-21	GASKET	(ADD)
24A					1	1	D3535-33	WEARSHOE (REPLACES D2656-33)	(MODIFY)
24B					1	1	D3536-33	GASKET	(ADD)
26A					44		MS27039-1C08	SCREW	(MODIFY)
26B					44		AN960C10L	WASHER	(MODIFY)

WAS:

20A					4		D2648-3	WEARPAD
21A					1		D3429-1	WEARPAD
22A					1	1	D2656-13	WEARSHOE
23A					1	1	D2656-21	WEARSHOE
24A					1	1	D2656-33	WEARSHOE
26A					44		MS27039-1-08	SCREW
26B					44		AN960JD10L	WASHER

DESIGN	AJS	<b>DART AEROSPACE LTD</b> HAWKESBURY, ONTARIO, CANADA	
DRAWN	AJS		
CHECKED		DRAWING NO.	REV. B
MFG. APPR.	N/A	DSI 9440	SHEET 2 OF 4
APPROVED		TITLE	SCALE
DE APPR.		WEARSHOE CHANGE	NTS
DATE	09.03.25	COPYRIGHT © 2008 BY DART AEROSPACE LTD THIS DOCUMENT IS PRIVATE AND CONFIDENTIAL AND IS SUPPLIED ON THE EXPRESS CONDITION THAT IT IS NOT TO BE USED FOR ANY PURPOSE OR COPIED OR COMMUNICATED TO ANY OTHER PERSON WITHOUT WRITTEN PERMISSION FROM DART AEROSPACE LTD.	

4.3 206 L/L-1/L-3/L-4/407 Low Gear & 407 High Gear Skidtubes (D206-642)  
 32.12 206 L/L-1/L-3/L-4/407 Low Gear & 407 High Gear Skidtubes (ICA-D206-642)

ITEM	Qty -311	Qty -312	Qty -341	Qty -347	Qty -013	PART NUMBER	DESCRIPTION
	X					D206-642-311	SKIDTUBE INSTALLATION, LH
		X				D206-642-312	SKIDTUBE INSTALLATION, RH
	1	1	X			D206-642-341	SKIDTUBE
				X		D206-642-347	WEARSHOE KIT (REPLACES -343)
	1	1			X	D206-648-013	GROUND HANDLING KIT

IS:

20A			6			D3537-1	WEARPAD (REPLACES D2648-3)	(MODIFY)
21A			1			D3537-3	WEARPAD (REPLACES D3429-1)	(MODIFY)
22A			1	1		D3535-11	WEARSHOE (REPLACES D2656-11)	(MODIFY)
22B			1	1		D3536-11	GASKET	(ADD)
23A			1	1		D3535-23	WEARSHOE (REPLACES D2656-23)	(MODIFY)
23B			1	1		D3536-23	GASKET	(ADD)
24A			1	1		D3535-35	WEARSHOE (REPLACES D2656-35)	(MODIFY)
24B			1	1		D3536-35	GASKET	(ADD)
26A			54			MS27039-1C08	SCREW	(MODIFY)
26B			54			AN960C10L	WASHER	(MODIFY)

WAS:

20A			6			D2648-3	WEARPAD
21A			1			D3429-1	WEARPAD
22A			1	1		D2656-11	WEARSHOE
23A			1	1		D2656-23	WEARSHOE
24A			1	1		D2656-35	WEARSHOE
26A			54			MS27039-1-08	SCREW
26B			54			AN960JD10L	WASHER

4.4 206L/L-1/L-3/L-4 High Gear Skidtubes (D206-642)  
 32.13 206L/L-1/L-3/L-4 High Gear Skidtubes (ICA-D206-642)

ITEM	Qty -411	Qty -412	Qty -441	Qty -447	Qty -013	PART NUMBER	DESCRIPTION
	X					D206-642-411	SKIDTUBE INSTALLATION, LH
		X				D206-642-412	SKIDTUBE INSTALLATION, RH
	1	1	X			D206-642-441	SKIDTUBE
				X		D206-642-447	WEARSHOE KIT (REPLACES -443)
	1	1			X	D206-648-013	GROUND HANDLING KIT

IS:


20A			6			D3537-1	WEARPAD (REPLACES D2648-3)	(MODIFY)
21A			1			D3537-3	WEARPAD (REPLACES D3429-1)	(MODIFY)
22A			1	1		D3535-15	WEARSHOE (REPLACES D2656-15)	(MODIFY)
22B			1	1		D3536-15	GASKET	(ADD)
23A			1	1		D3535-23	WEARSHOE (REPLACES D2656-23)	(MODIFY)
23B			1	1		D3536-23	GASKET	(ADD)
24A			1	1		D3535-37	WEARSHOE (REPLACES D2656-37)	(MODIFY)
24B			1	1		D3536-37	GASKET	(ADD)
26A			60			MS27039-1C08	SCREW	(MODIFY)
26B			60			AN960C10L	WASHER	(MODIFY)

WAS:

20A			6			D2648-3	WEARPAD
21A			1			D3429-1	WEARPAD
22A			1	1		D2656-15	WEARSHOE
23A			1	1		D2656-23	WEARSHOE
24A			1	1		D2656-37	WEARSHOE
26A			60			MS27039-1-08	SCREW
26B			60			AN960JD10L	WASHER


DESIGN	AJS	<b>DART AEROSPACE LTD</b> HAWKESBURY, ONTARIO, CANADA	
DRAWN	AJS		
CHECKED	<del>NA</del>	DRAWING NO.	REV. 3
MFG. APPR.	N/A	DSI 9440	SHEET 3 OF 4
APPROVED	<del>NA</del>	TITLE	SCALE
DE APPR.	<del>NA</del>	WEARSHOE CHANGE	NTS
DATE	09.03.25	COPYRIGHT © 2008 BY DART AEROSPACE LTD THIS DOCUMENT IS PRIVATE AND CONFIDENTIAL AND IS SUPPLIED ON THE EXPRESS CONDITION THAT IT IS NOT TO BE USED FOR ANY PURPOSE OR COPIED OR COMMUNICATED TO ANY OTHER PERSON WITHOUT WRITTEN PERMISSION FROM DART AEROSPACE LTD.	

**206 A/B SKIDTUBES**  
(D206-642-111/-112/-211/-212/-213/-214)

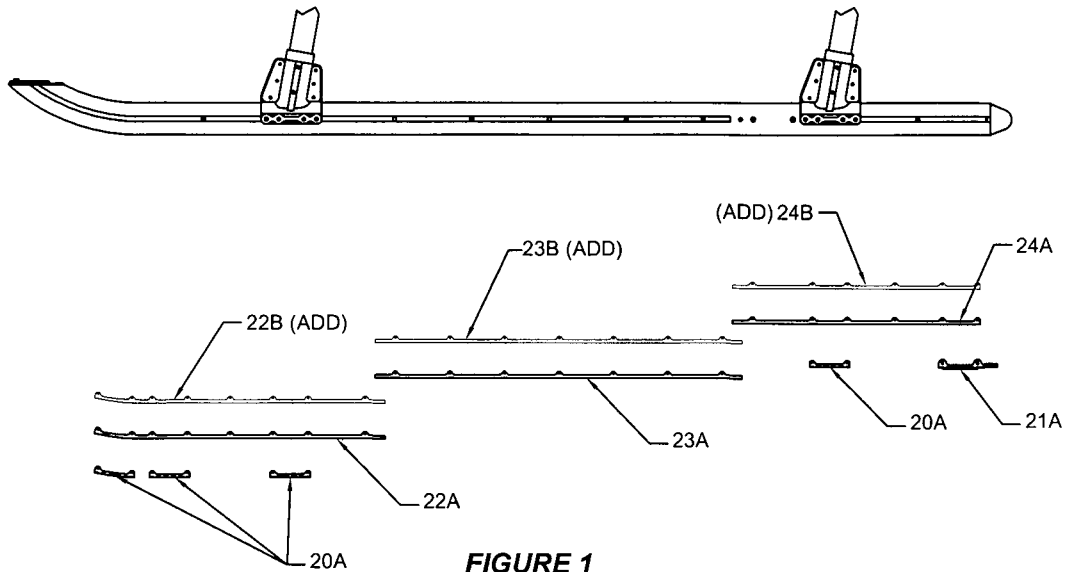




**FIGURE 1**

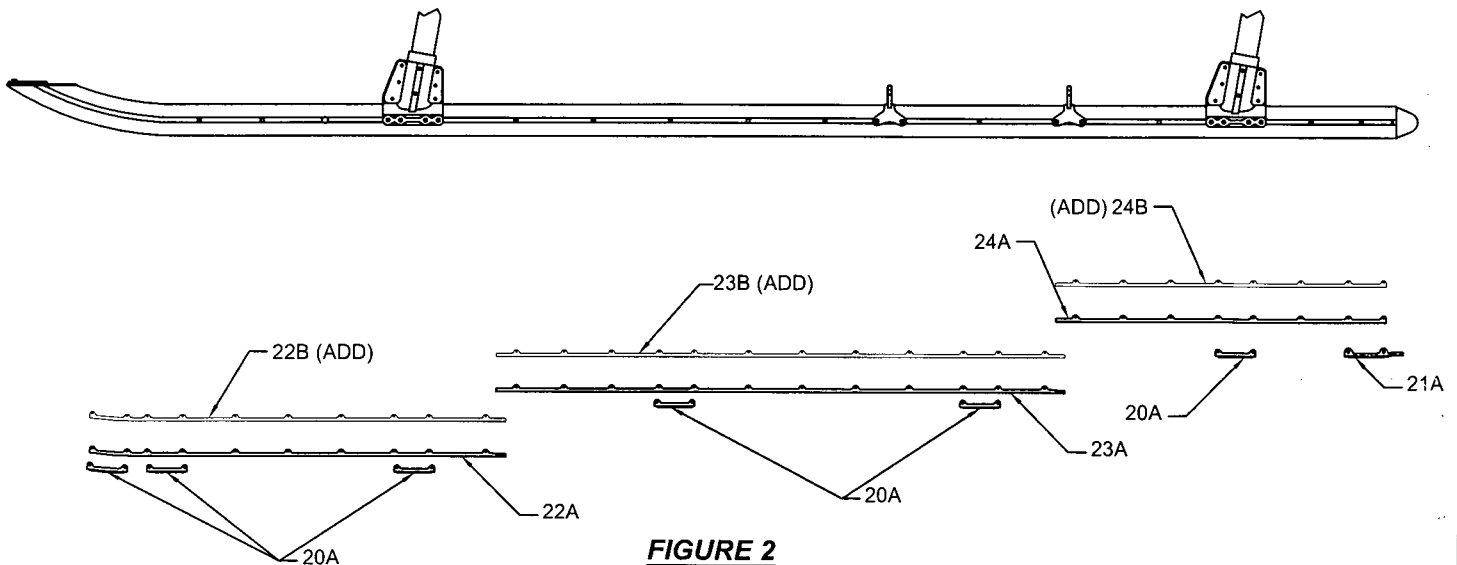**206 L/L-1/L-3/L-4/407 SKIDTUBES**  
(D206-642-311/-312/-411/-412)



**FIGURE 2**

DESIGN	AJS	<b>DART AEROSPACE LTD</b> <b>HAWKESBURY, ONTARIO, CANADA</b>	
DRAWN	AJS		
CHECKED		DRAWING NO.	REV. B
MFG. APPR.	N/A	DSI 9440	SHEET 4 OF 4
APPROVED		TITLE	SCALE
DE APPR.		WEARSHOE CHANGE	NTS
DATE	09.03.25	COPYRIGHT © 2008 BY DART AEROSPACE LTD THIS DOCUMENT IS PRIVATE AND CONFIDENTIAL AND IS SUPPLIED ON THE EXPRESS CONDITION THAT IT IS NOT TO BE USED FOR ANY PURPOSE OR COPIED OR COMMUNICATED TO ANY OTHER PERSON WITHOUT WRITTEN PERMISSION FROM DART AEROSPACE LTD.	